




SEC-1

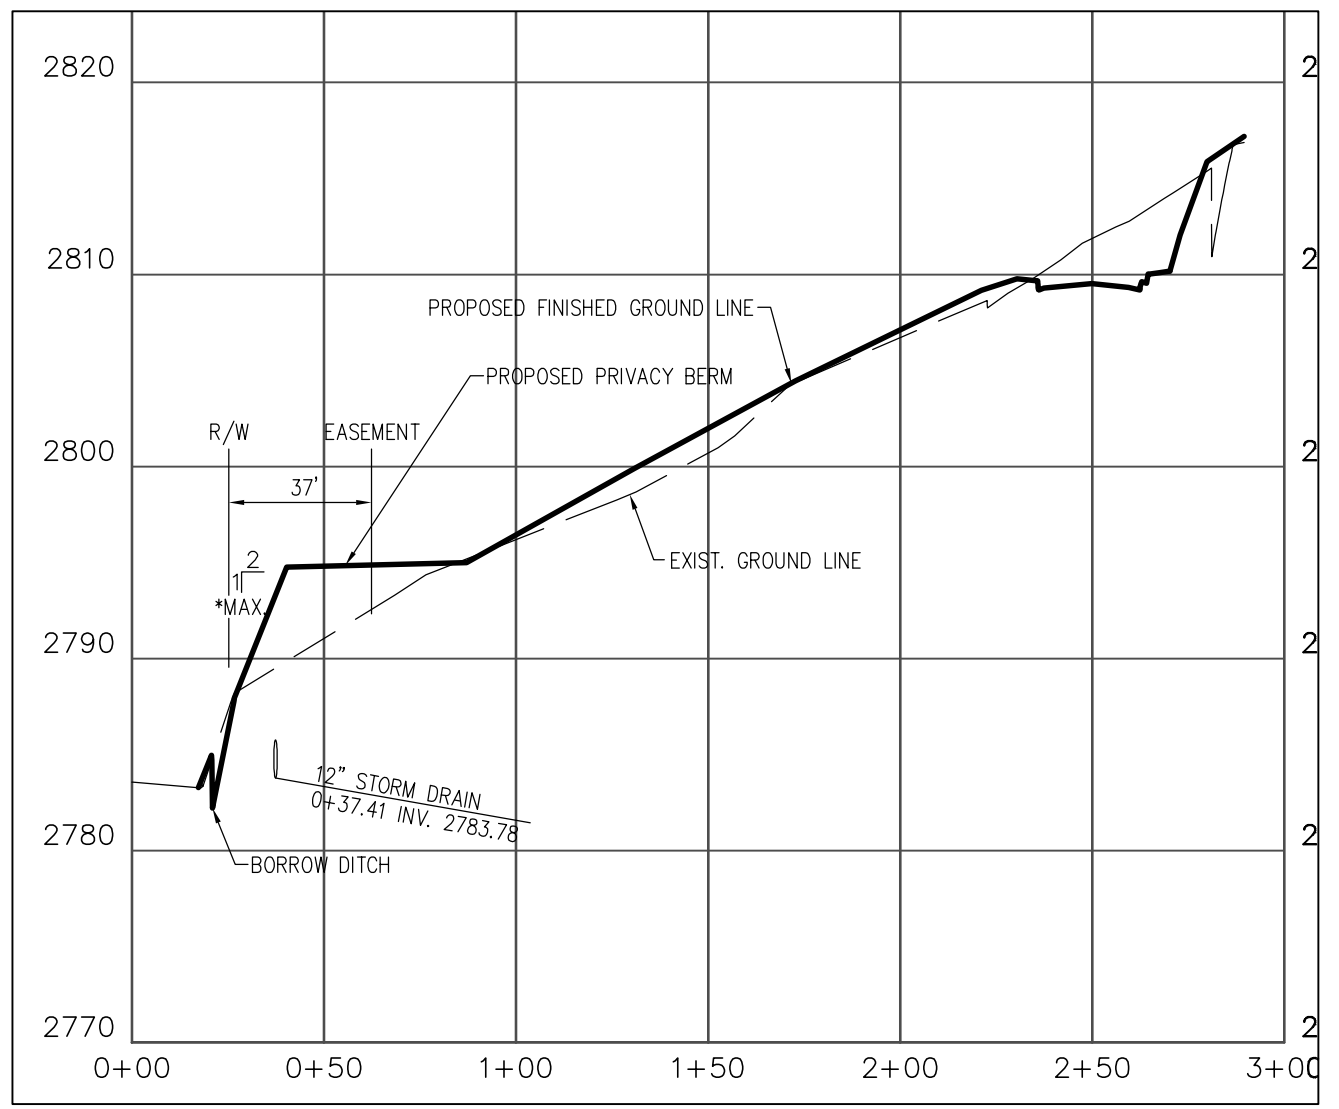

SEC-2

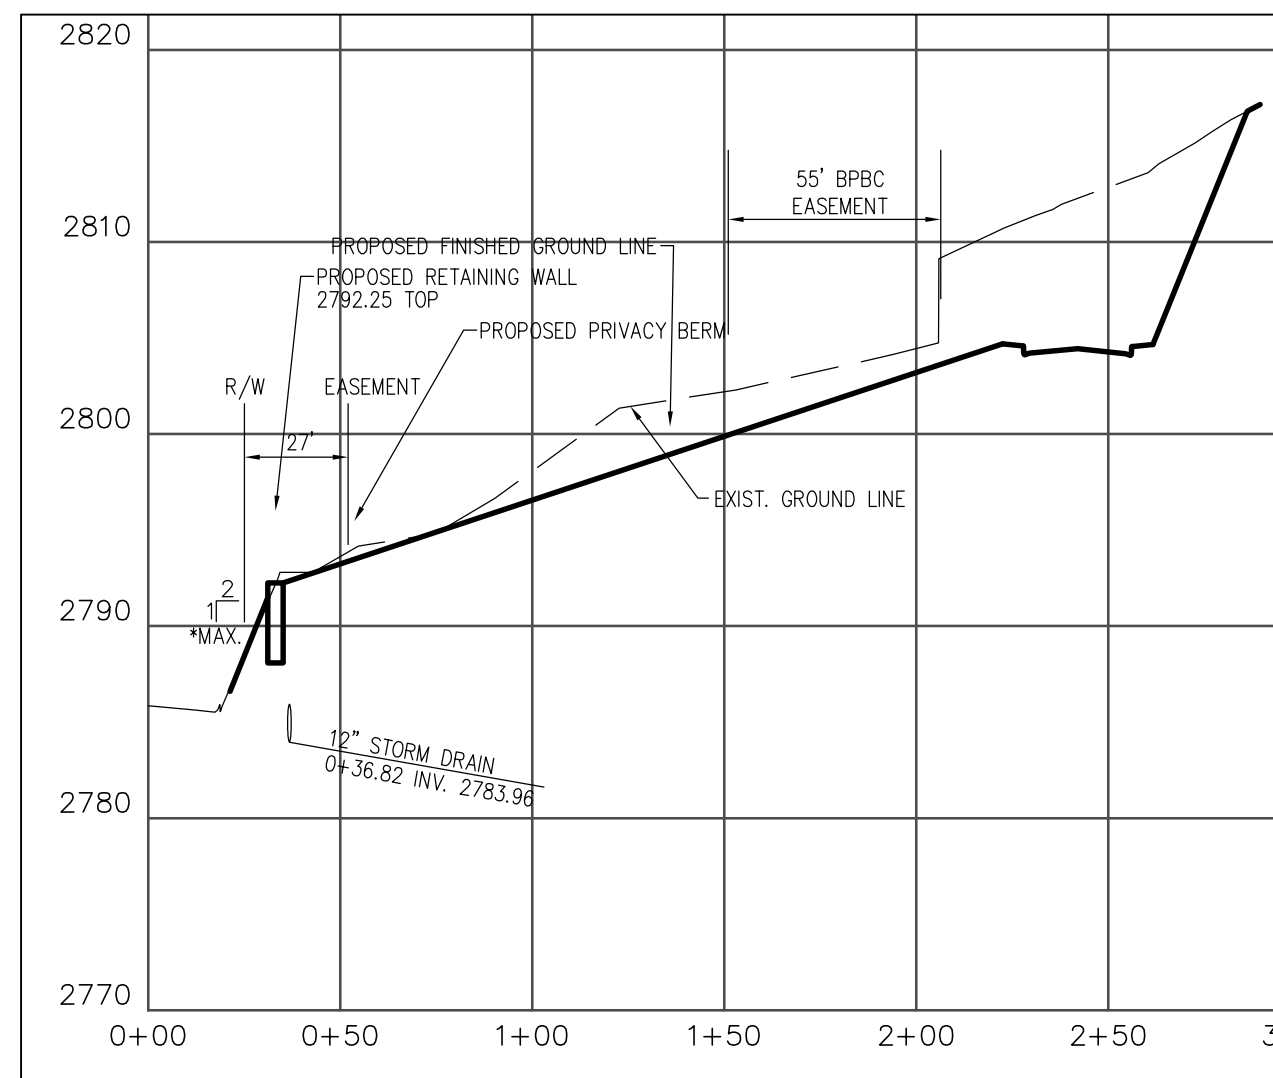


SEC-3

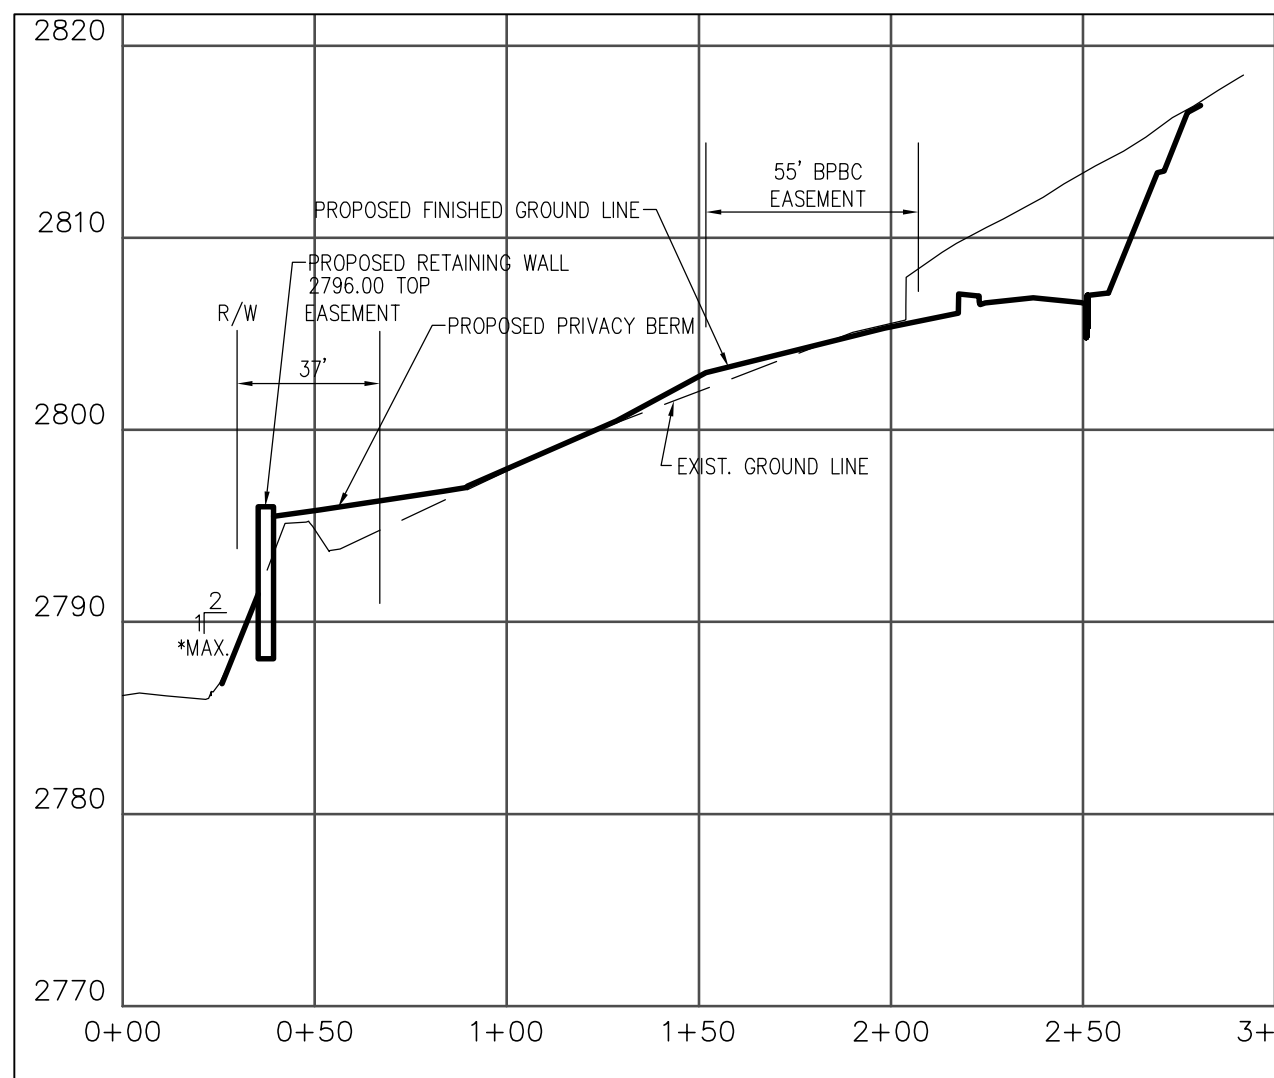


SEC-4

\* NOTE:  
SLOPES CAN BE STEEPER  
IF APPROVED BY GEOTECHNICAL  
ENGINEER.


SCALE  
VERT: 1" = 10'  
HORIZ: 1" = 50'

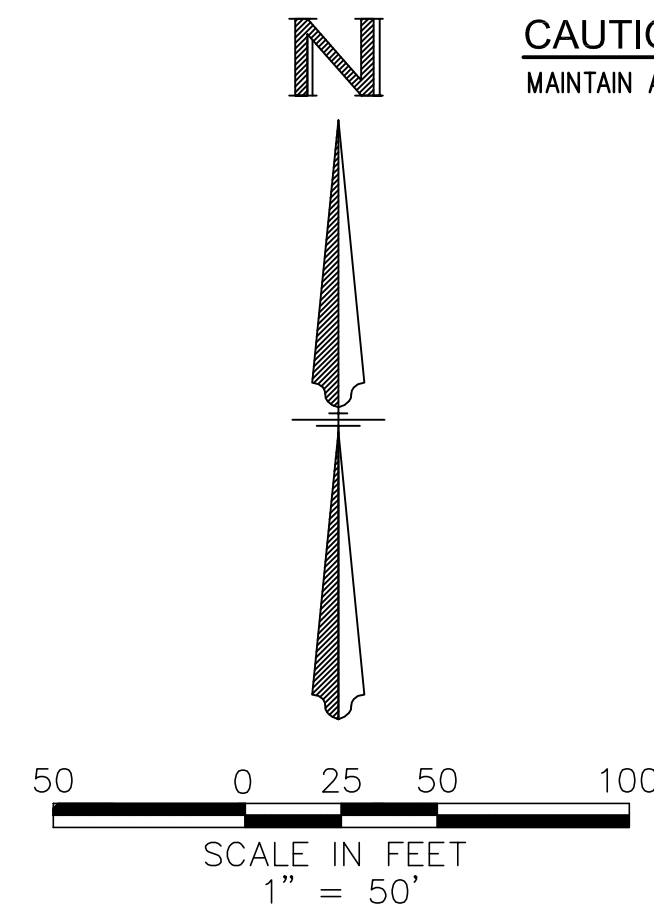


**CAUTION NOTE:**  
MAINTAIN A MINIMUM OF 2.5' OF COVER OVER EXIST. IRRIGATION PIPE.

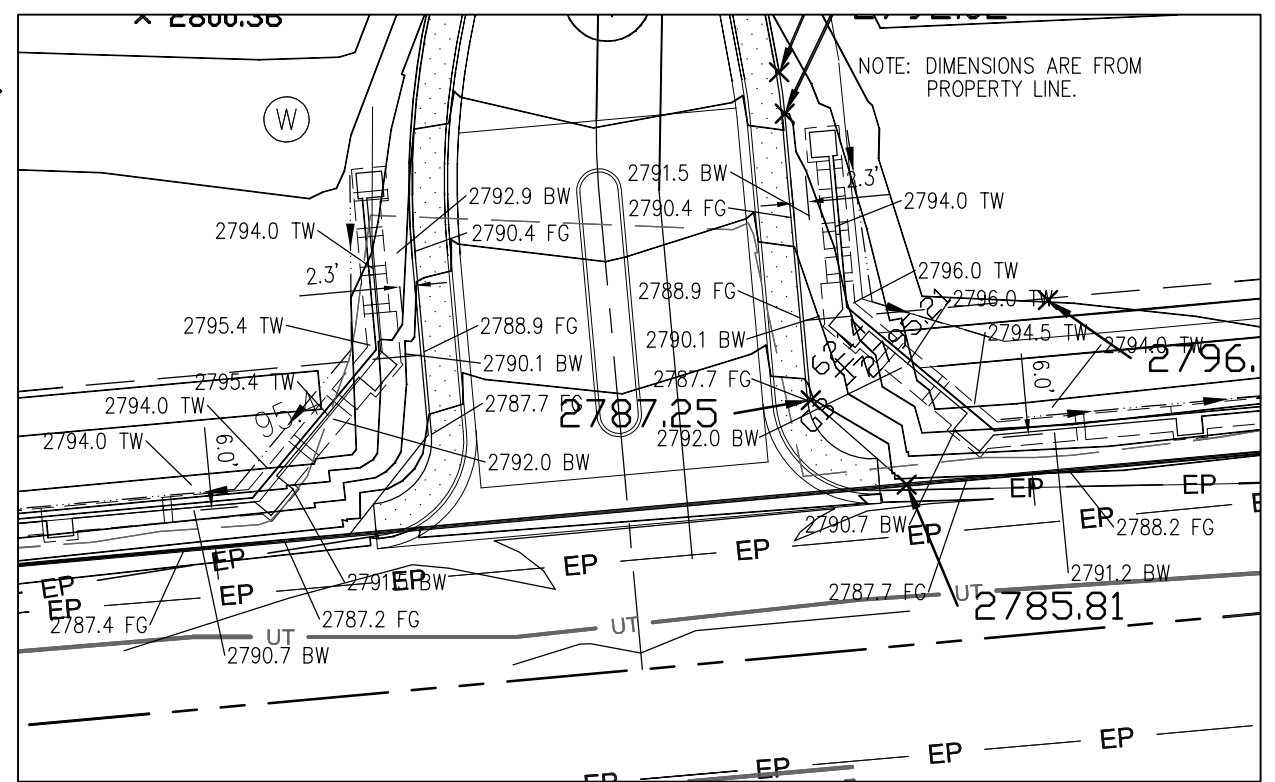

DETAIL "A"  
-NTS-

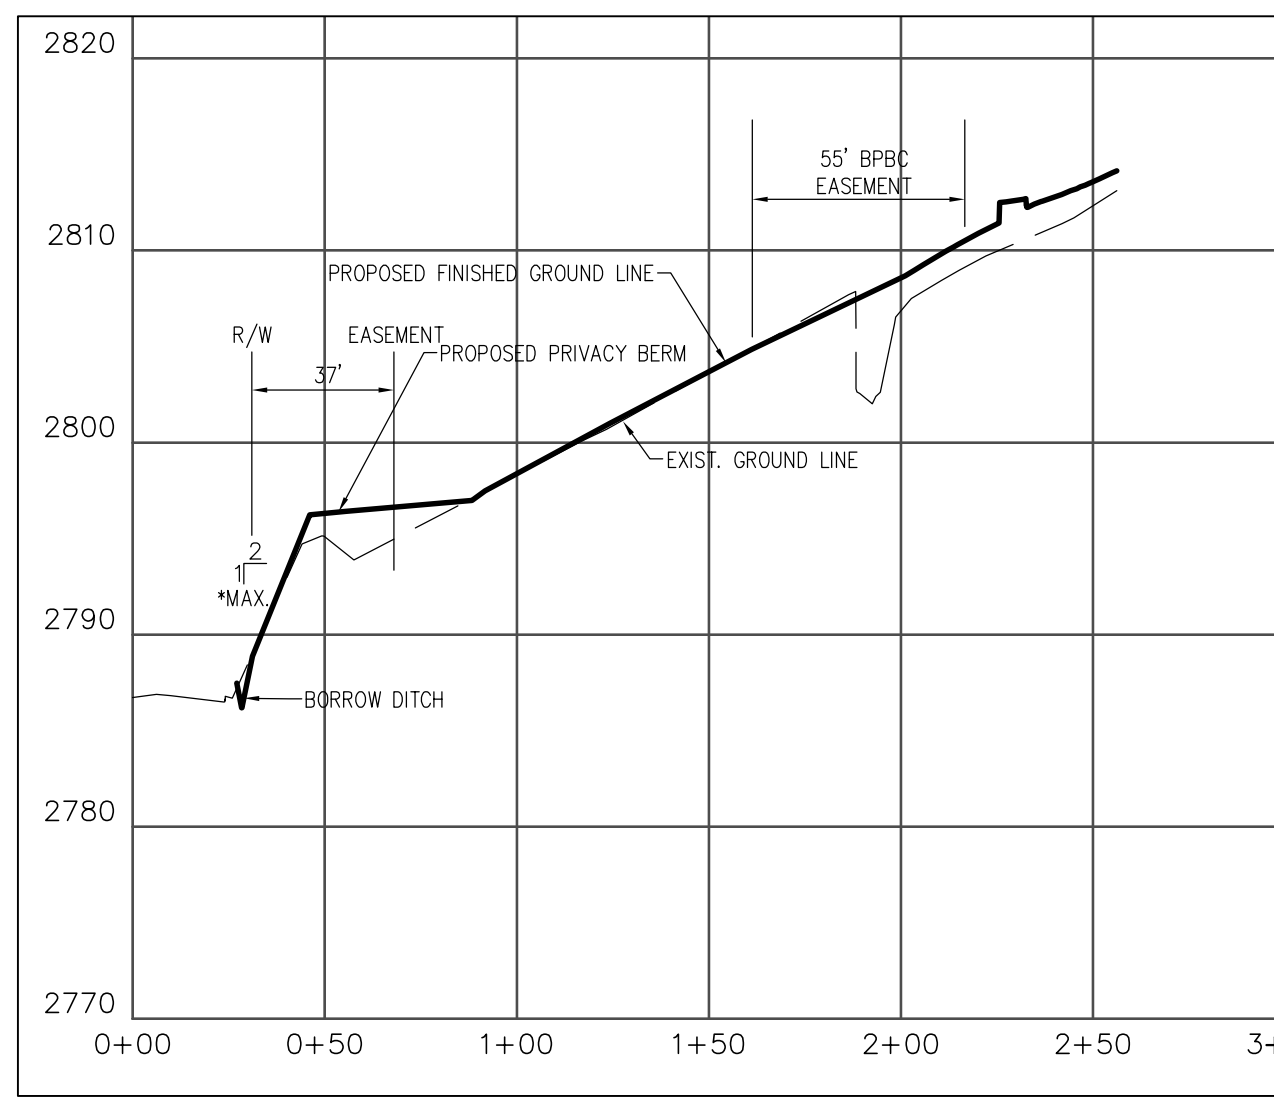

SEC-5

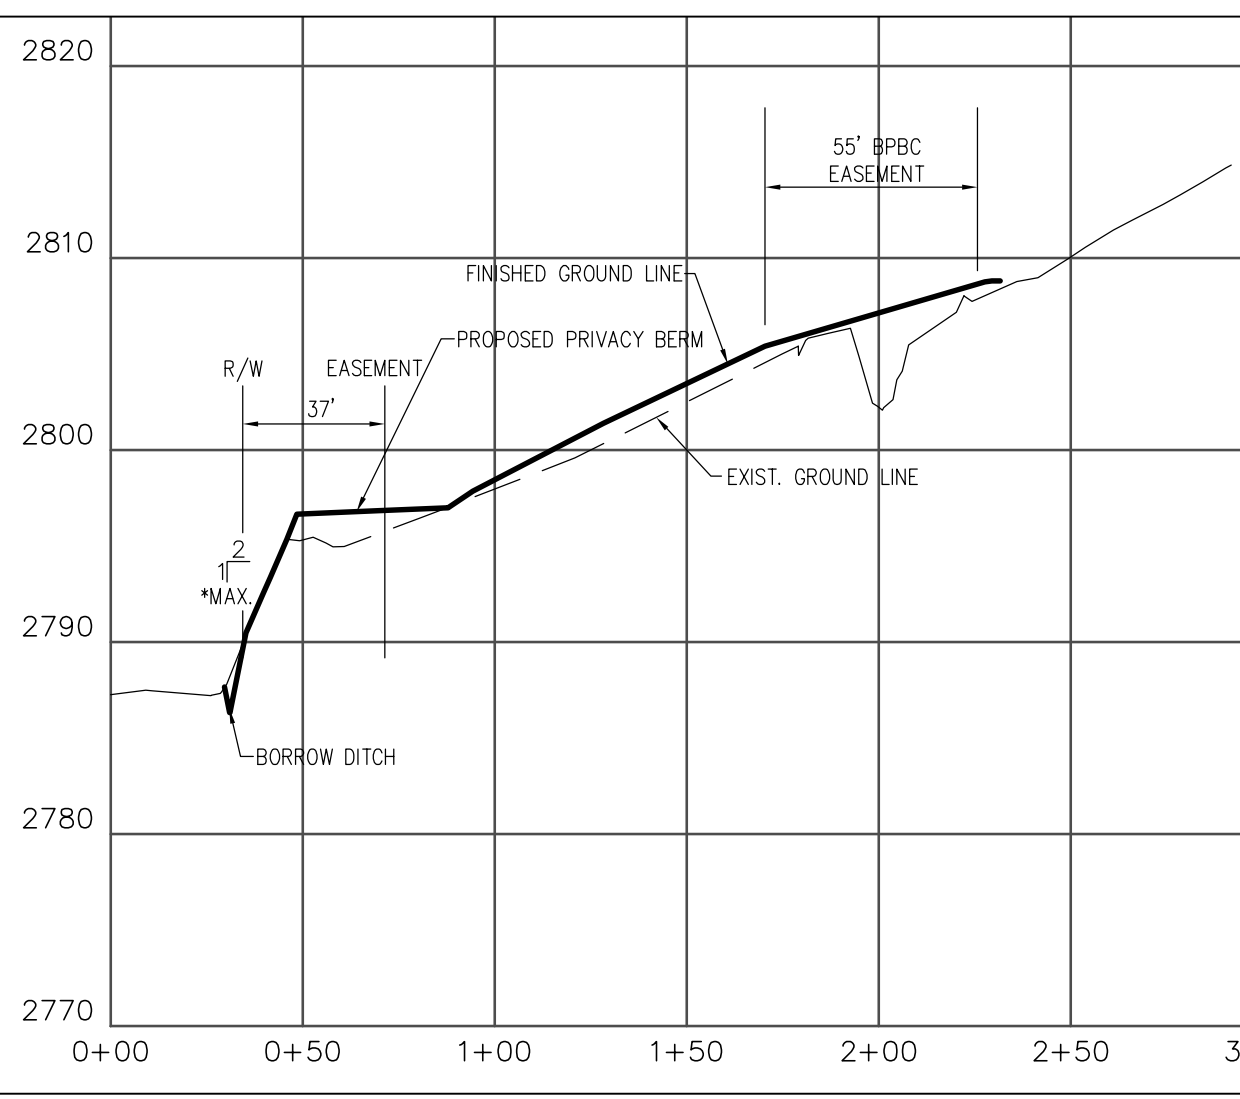

SEC-6

RECORD DRAWING

Revisions	
Date	Description
1	
2	
3	
4	

**ROCK SOLID CIVIL**  
Civil Engineering and Land Development Consulting  
181 East 50th Street, Garden City, ID 83714  
Office Phone: 208.342.3277  
www.rocksolidcivil.com

REUSE OF DRAWINGS  
THIS DOCUMENT AND THE IDEAS AND DESIGNS INCORPORATED HEREIN, AS AN INSTRUMENT OF PROFESSIONAL SERVICE IS THE PROPERTY OF ROCK SOLID CIVIL LLC AND IS NOT TO BE USED IN WHOLE OR PART, FOR ANY OTHER PROJECT WITHOUT THE EXPRESS WRITTEN AUTHORIZATION OF ROCK SOLID CIVIL LLC.

PRIVADA ESTATES  
LOT SECTIONS

Project Name  
Sheet Name  
Stamp  
**PROFESSIONAL ENGINEER**  
REGISTERED  
STATE OF IDAHO  
10692  
JIM E. COSLETT

Project No. RSC-1310  
Drawn By: RLC  
Date: December 3, 2015  
Sheet No. **3**  
3 of 8